



Do not scale from this drawing all dimensions must be checked on site.


NW07/2477/L

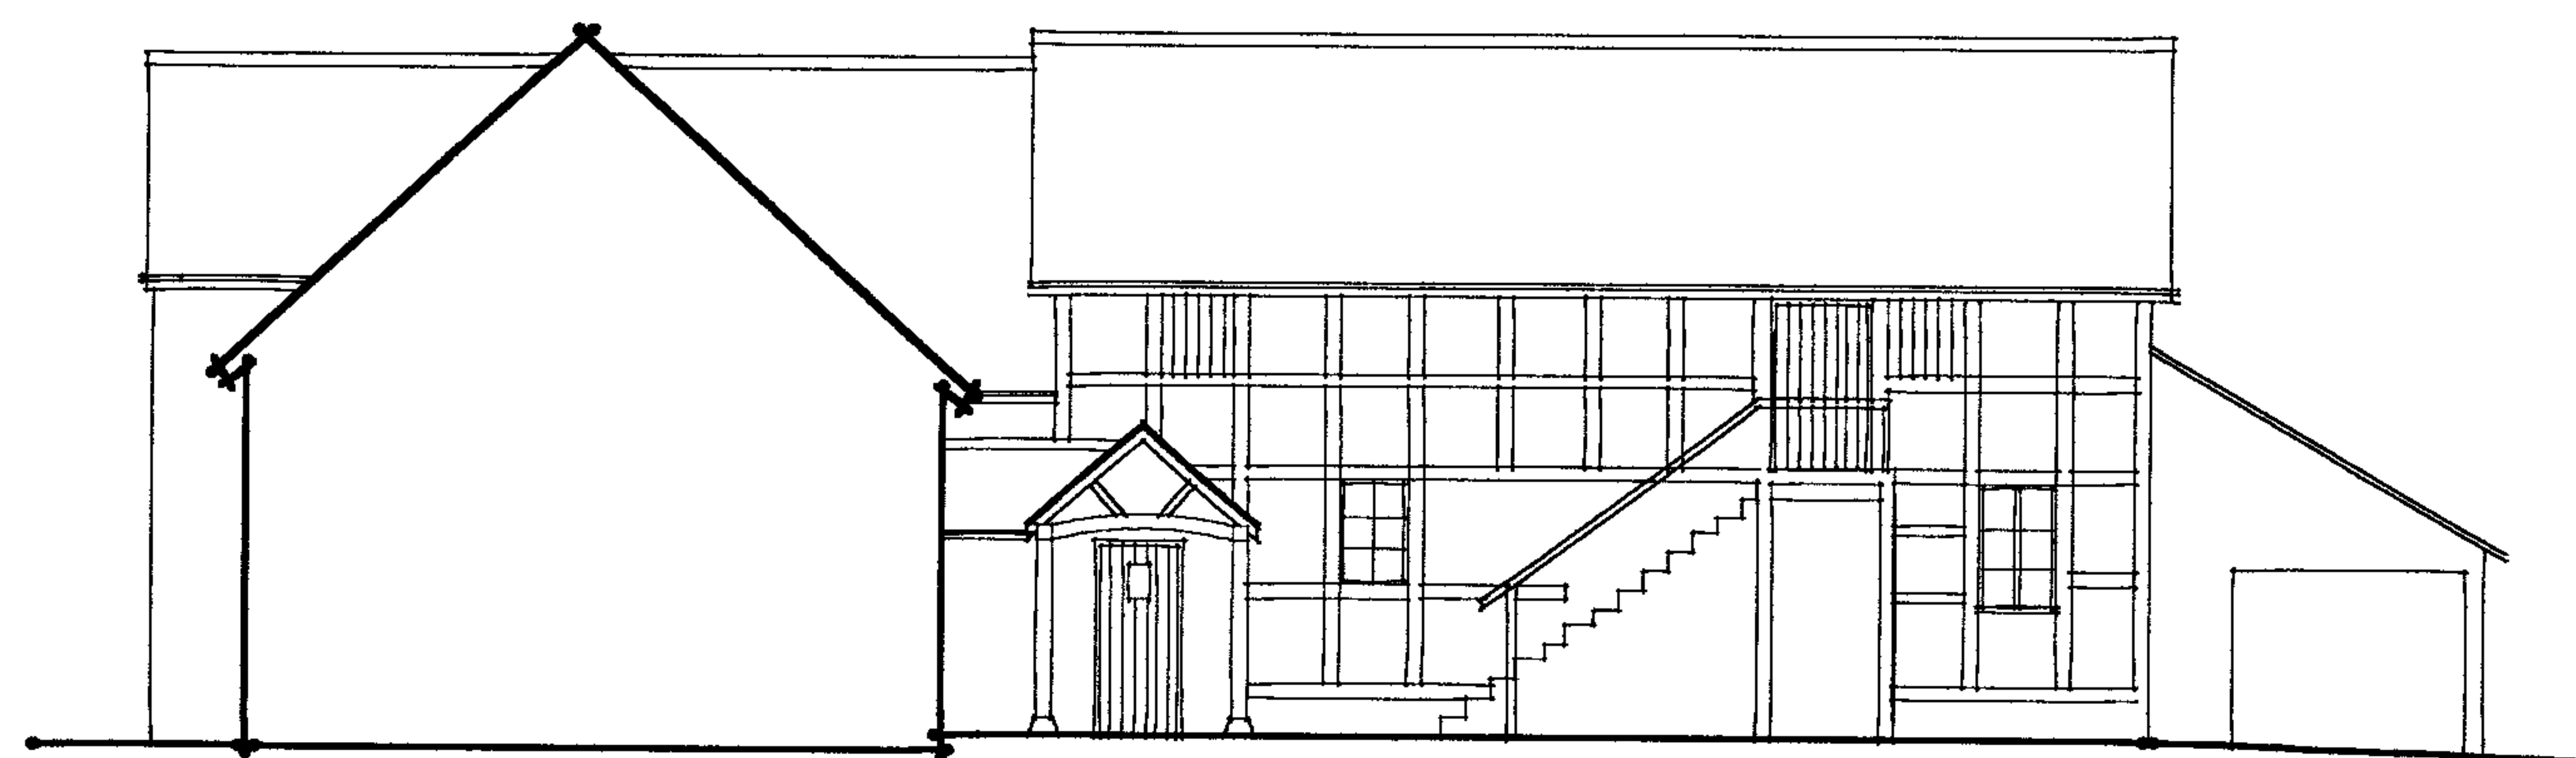

North elevation

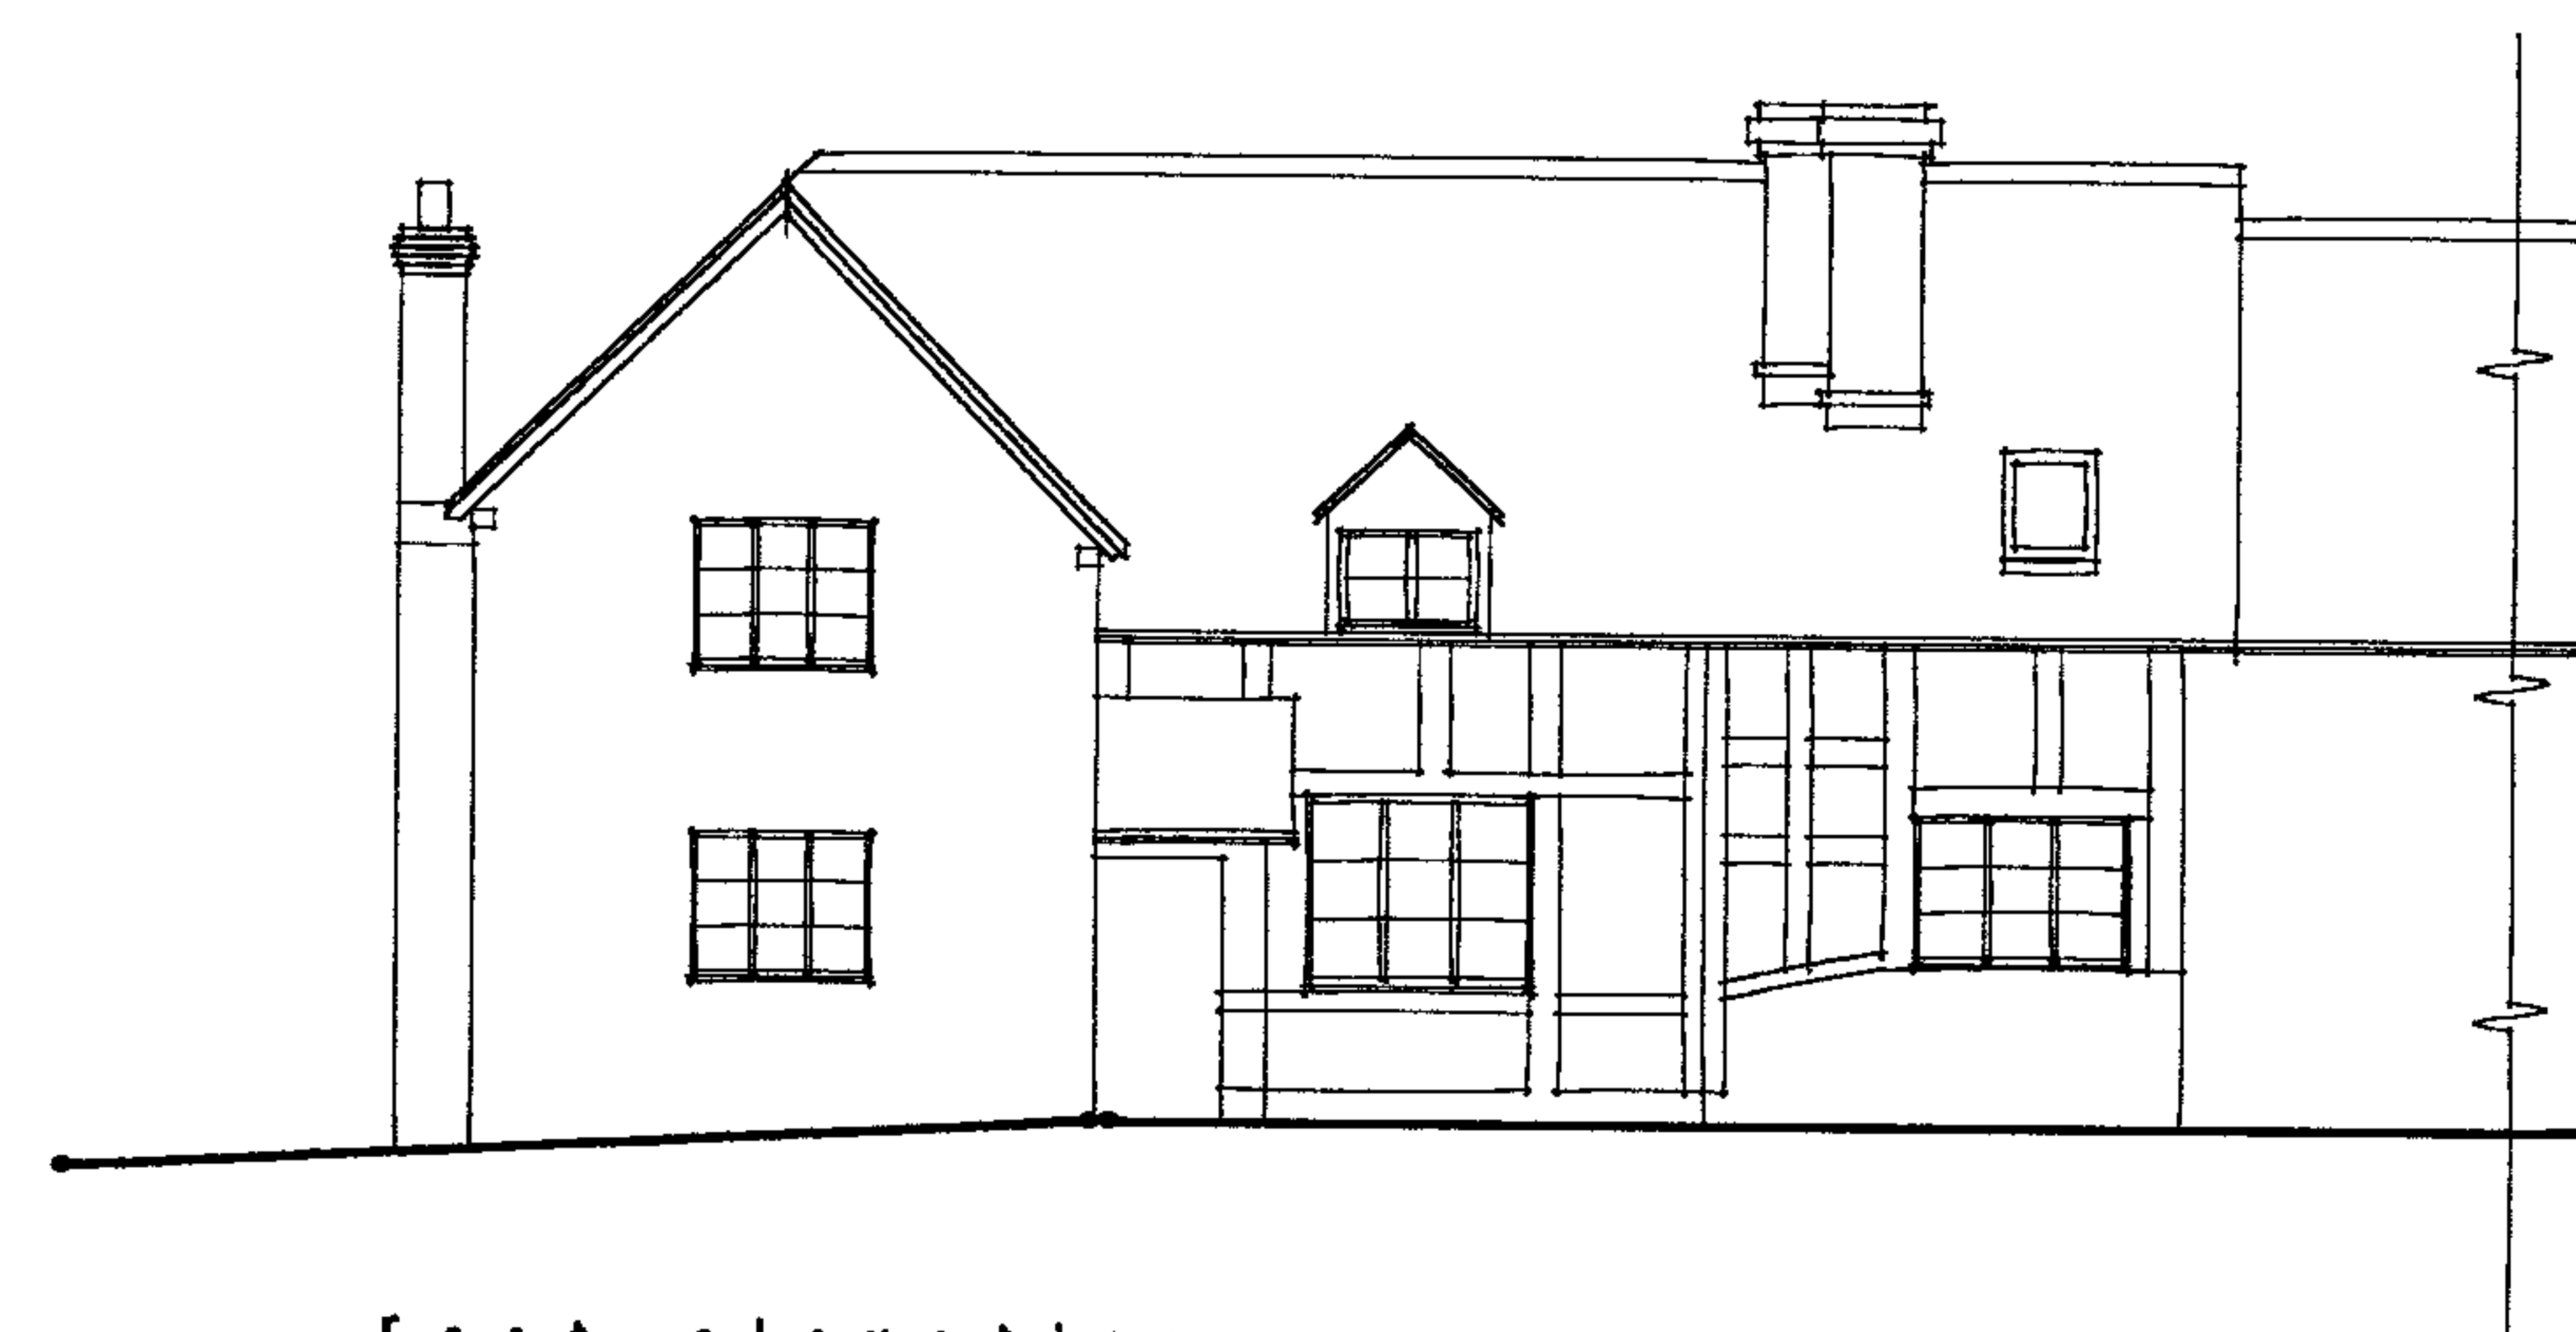


East elevation

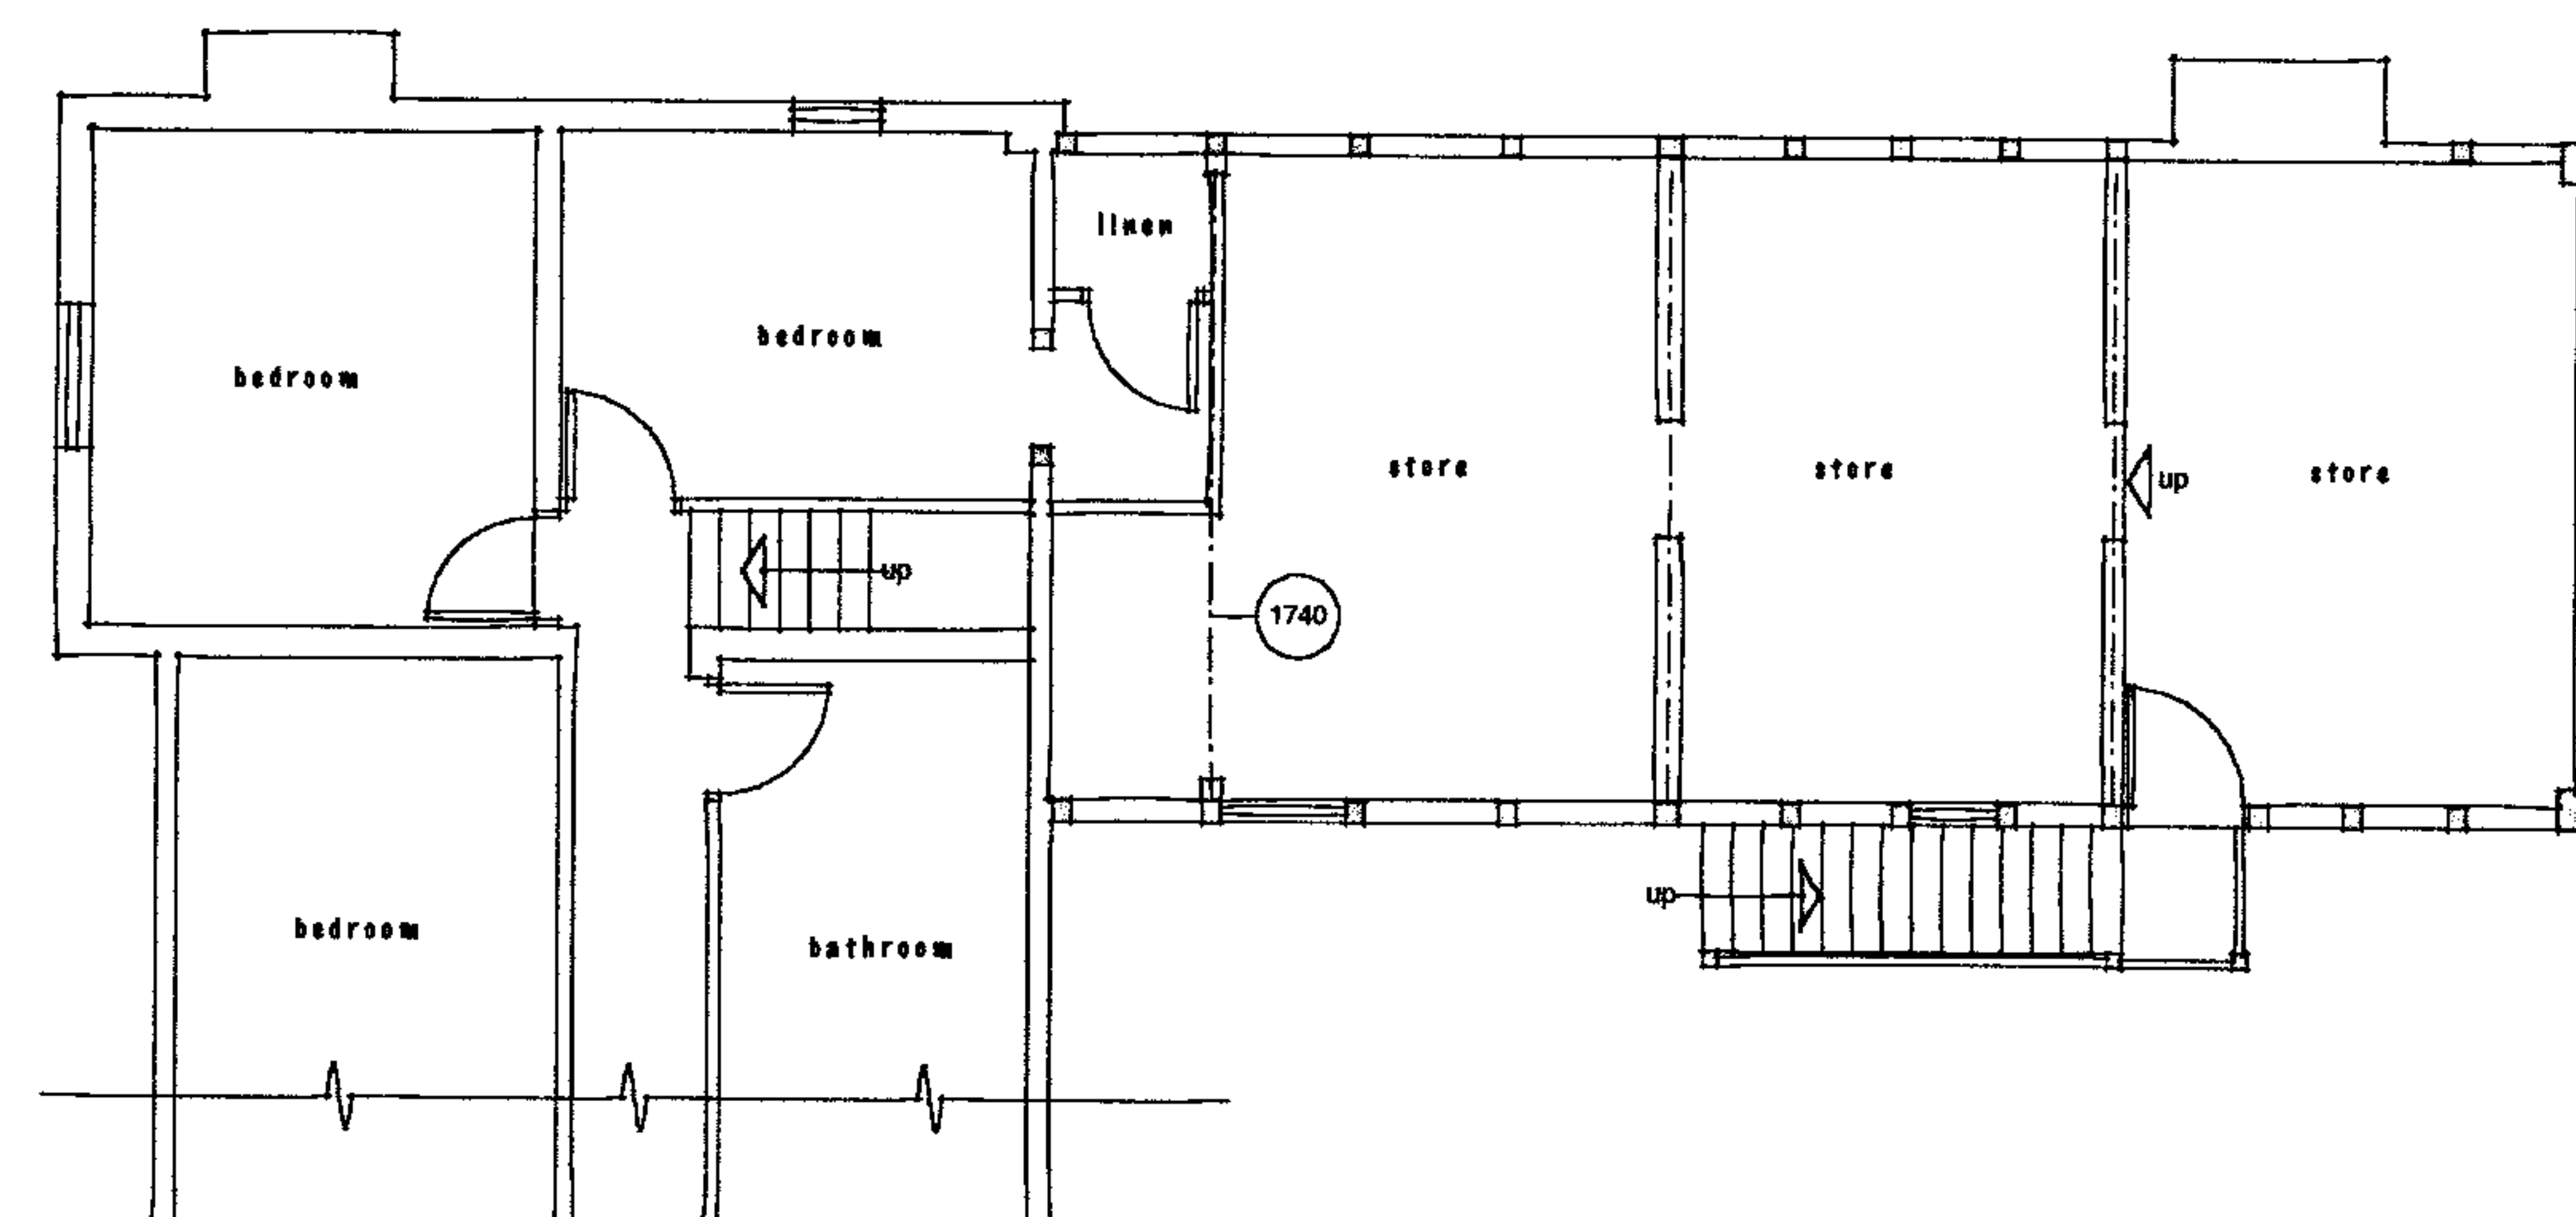


First floor plan



West elevation

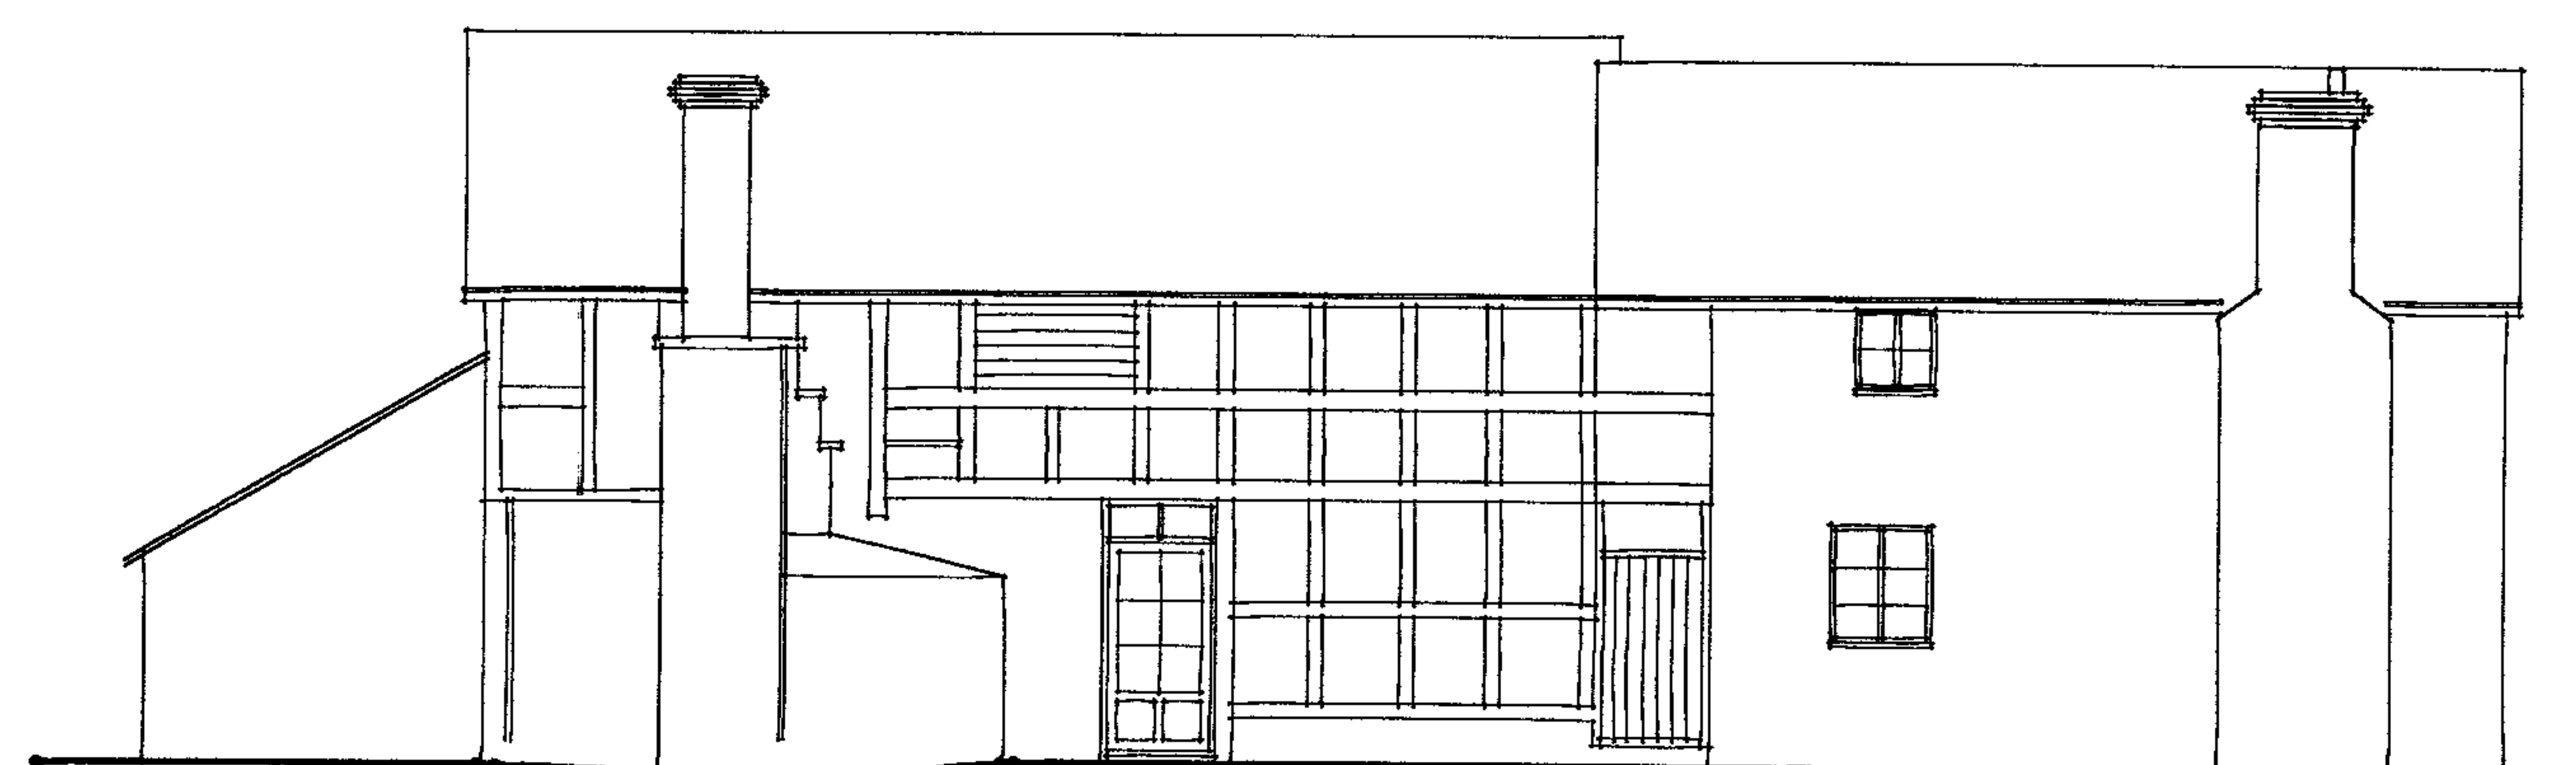

South elevation

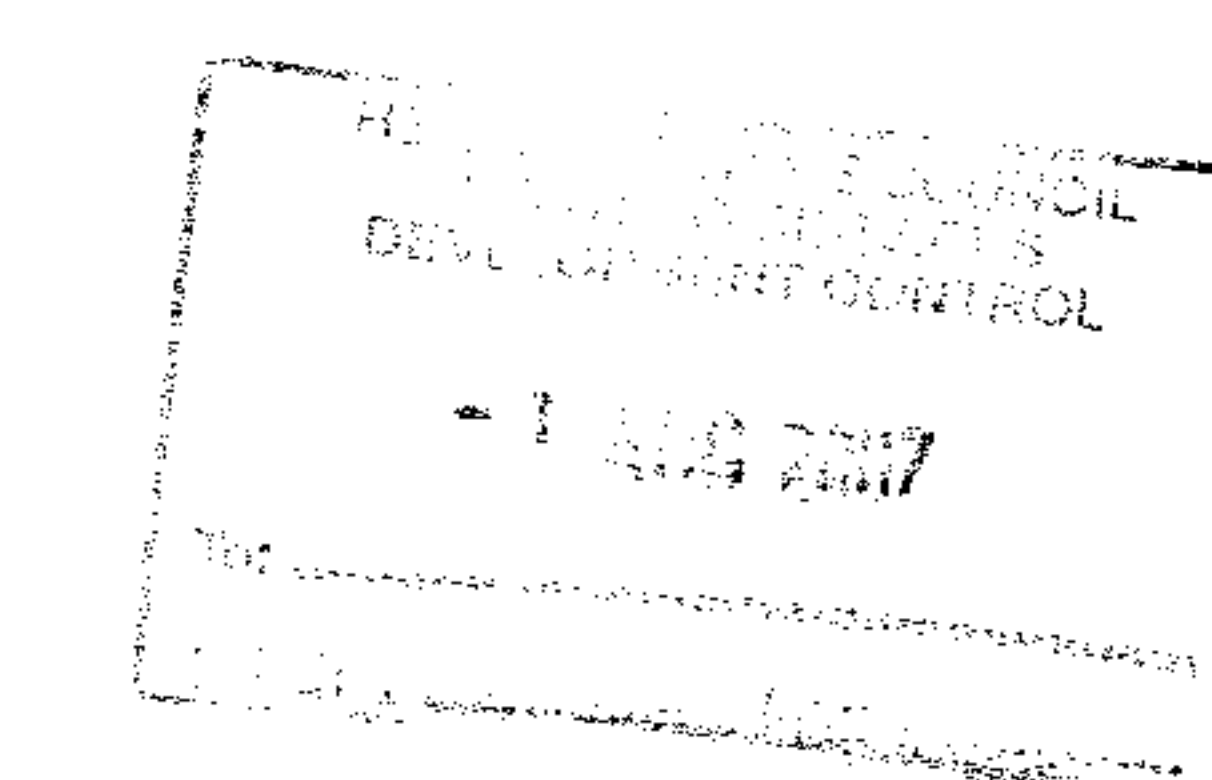

	JAMES SPRECKLEY MRICS FRAV	<small> 28 Sheep House Hereford HR4 7AS Tel: 01432 791777 Fax: 01432 791722 </small>	April 2006 Scale 1:100
Proposed alterations at Upper Broxwood Farm, Herefordshire.		■ This is not a complete working drawing: for Planning and Building Regulation use only. Additional information may be required as the work proceeds. □ This is a scheme based on an enlarged O.S. extract and as such is subject to a site survey. ■ Services and ground investigations were not available at the date of this drawing. ■ Crown Copyright Reserved. This drawing is for use only with named site and is Copyright.	<input type="checkbox"/> Preliminary <input checked="" type="checkbox"/> First issue <input type="checkbox"/> Revision
Floor plans & elevations as built.		Drawing No 1299. 01	