

ARQIVA DSO 6No. LOG PERIODICS AT 33.1m - 34.6m BEARINGS 160° & 310° E.T.N. ID No. 231700

CTIL 1No 0.6m DISH AT 31.5m BEARING 124° E.T.N. I.D. No. 380501

ARQIVA DSO 1No. LOG PERIODIC AT 30.0m BEARING 100° E.T.N. ID No. 231699
AIRWAVE 1No. 0.3m DISH AT 30.0m BEARING 284° E.T.N. ID No. 229194
AIRWAVE 1 o. 0.3m DISH AT 30.0m BEARING 175° E.T.N. ID No. 229193

H3G & EE 2No. COMMSCOPE CVV65BSX-3X ANTENNAS AT 24.6m MEAN BEARINGS
170° & 310° E.T.N. ID No's. 362574 & 362575

4No. LDF7-50 FEEDERS FOR 2100

2No. LDF5-50 FEEDERS FOR 800


CTIL 3No. KATHERIN 80010664 ANTENNAS AT 24.7m MEAN
BEARINGS 90°, 210° & 330° E.T.N. I.D. No's 410157, 410158 & 410159
EE 1No. 0.6m DISH AT 25.0m BEARING 111° E.T.N. ID No. 225177

EE 1No. 0.6m DISH AT 27.0m MEAN, BEARING 179° E.T.N. I.D. No. 369983

AIRWAVE 3No. 4 STACK DIPOLES AT 20.1m - 22.7m BEARINGS 70°, 190° & 310° E.T.N. ID No's. 229802 TO 229804

MBNL 1 No. 0.6m DISH AT 18.2m BEARING 312° E.T.N. I.D. No. 323437 - MBNL HFD080

MIP 1 No. 1.2m DISH AT 18.2m BEARING 312° E.T.N. I.D. No. 332151 - CTIL 8386VF

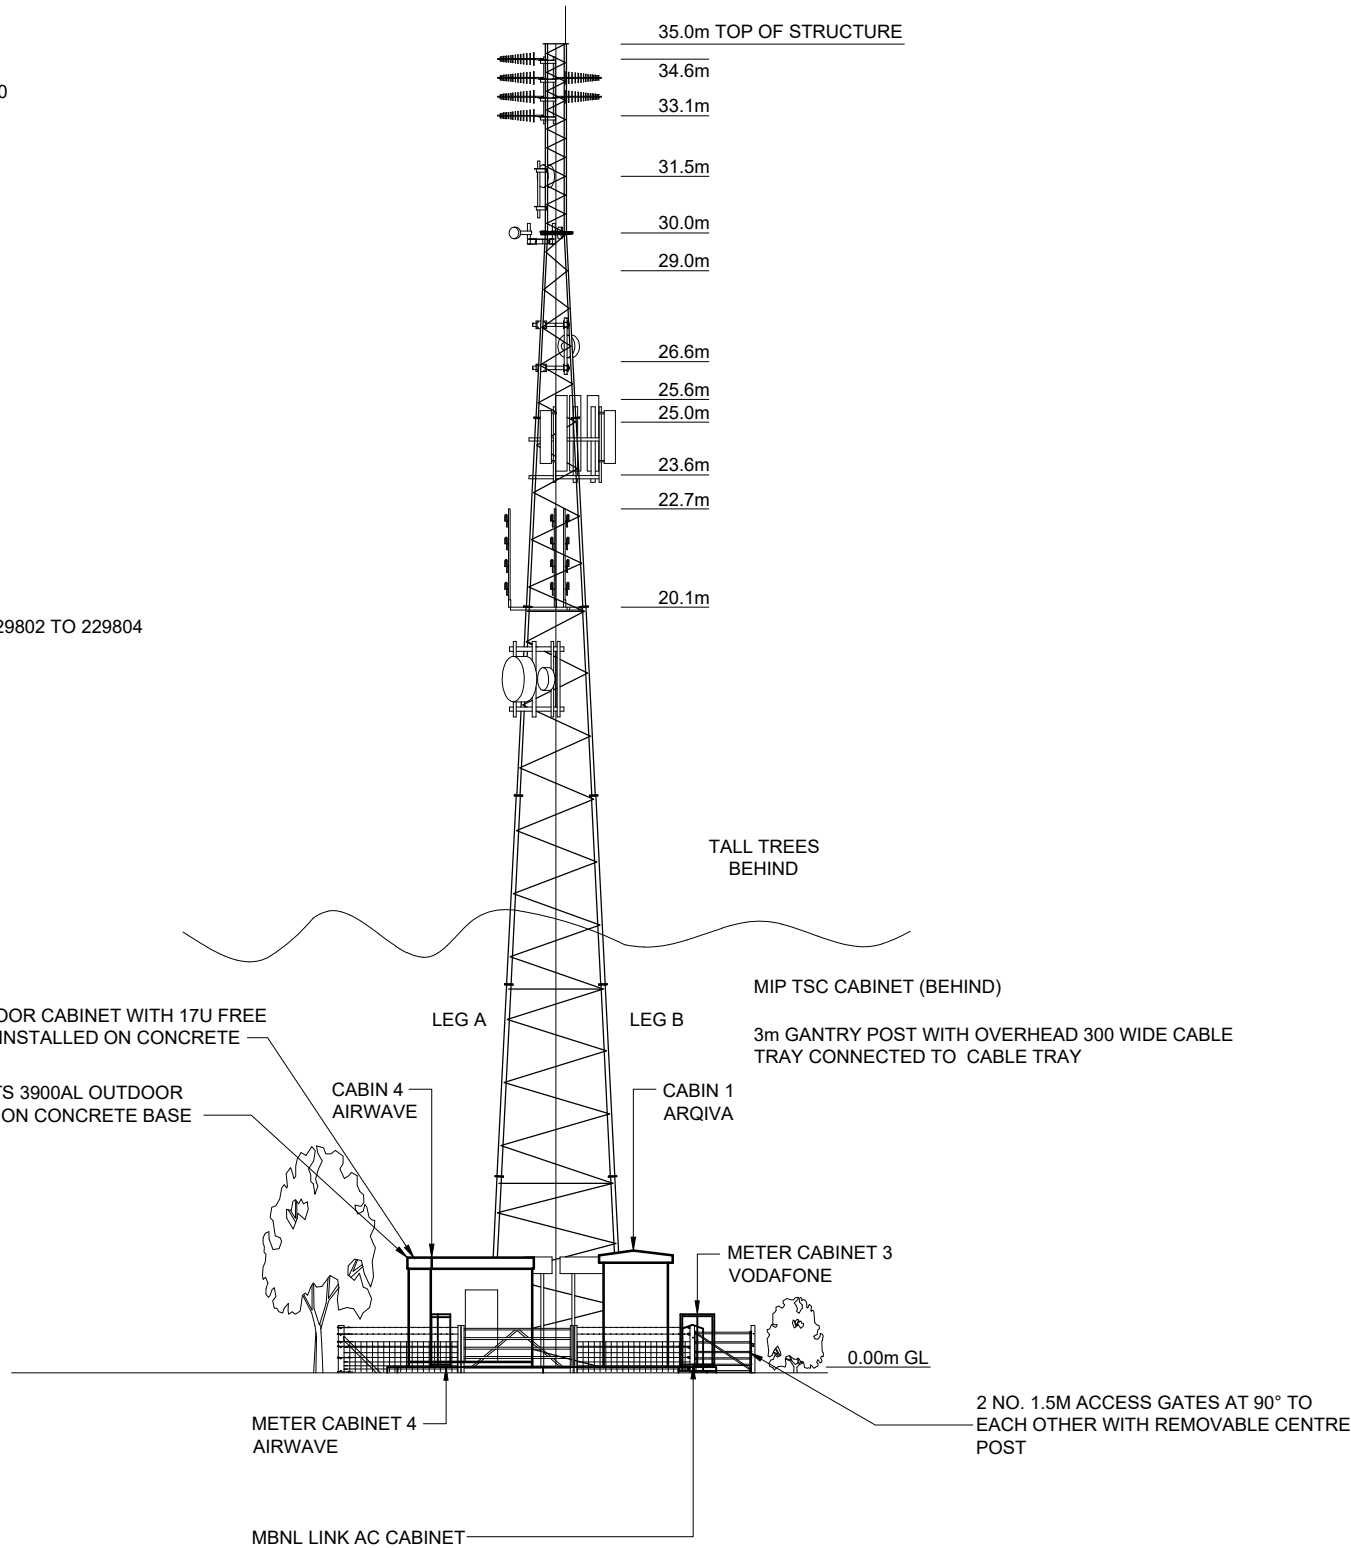

NOTES					
26	PROJ No	191127			
	AS BUILT		28/11/17	OBL	FC
25	PROJ No	169149			
	AS BUILT		25/10/17	HFC	FC
	AMEND				
24	PROJ No	169149			
	AS BUILT		23/10/17	HFC	FC
23	PROJ No	191127			
	PLANNING DRAWINGS		31/09/17	OBL	LBG
22	PROJ No	171768			
	AS BUILT		29/08/17	DAL	AN
ISS	REVISION		DATE	DRN	APP
arqiva Crawley Court, Winchester, Hampshire, SO21 2QA Tel. 01962 823434, Fax. 01962 822378 SITE No 14910 PETERCHURCH POSTON LODGE FARM VOWCHURCH HEREFORDSHIRE HR2 0RJ NGR SO 36001 38000 OS GRID 336001 238000 TITLE ELEVATION EXISTING SOUTH WEST SCALE 1:200 DRAWN 25/08/09 APPROVED FC 28/11/17 DRG No. Sheet 1 of 1 Rev 14910-00-002-MD026 26					