



— contour as built
--- contour as existing

Key Plan
1 : 50

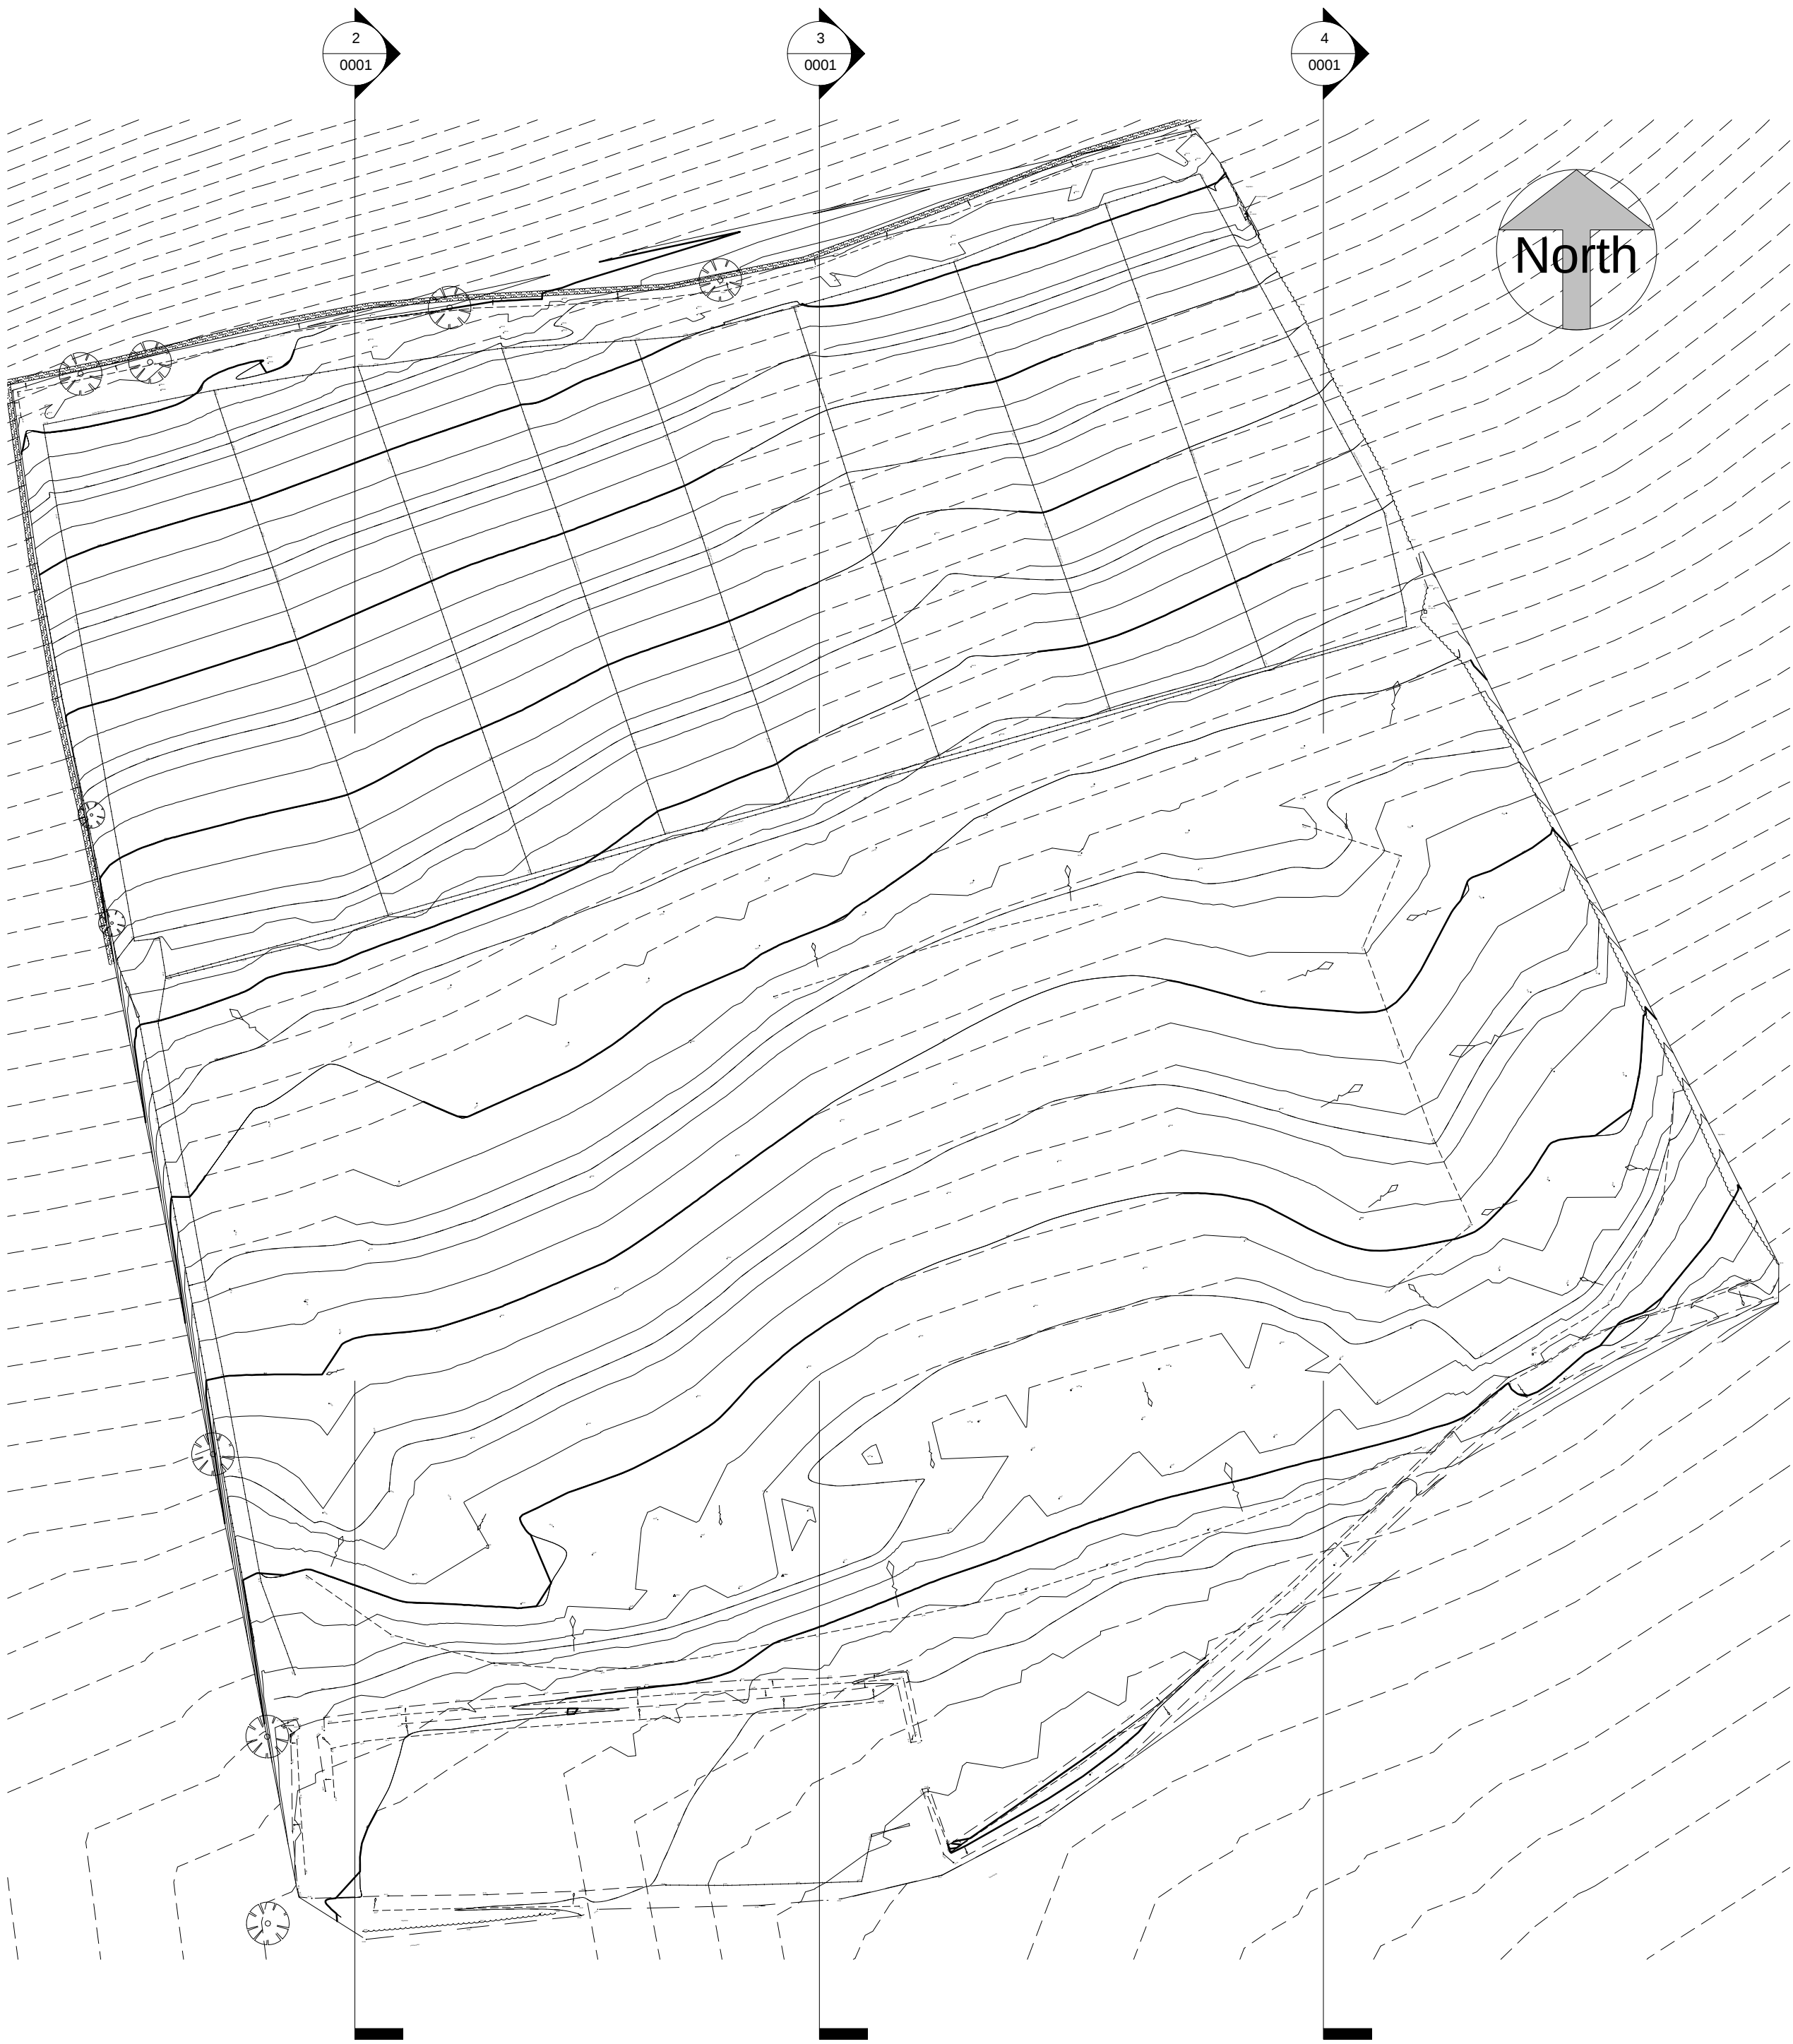


1 Site Plan as Proposed
1 : 1000


2 SECTION 01
1 : 1000

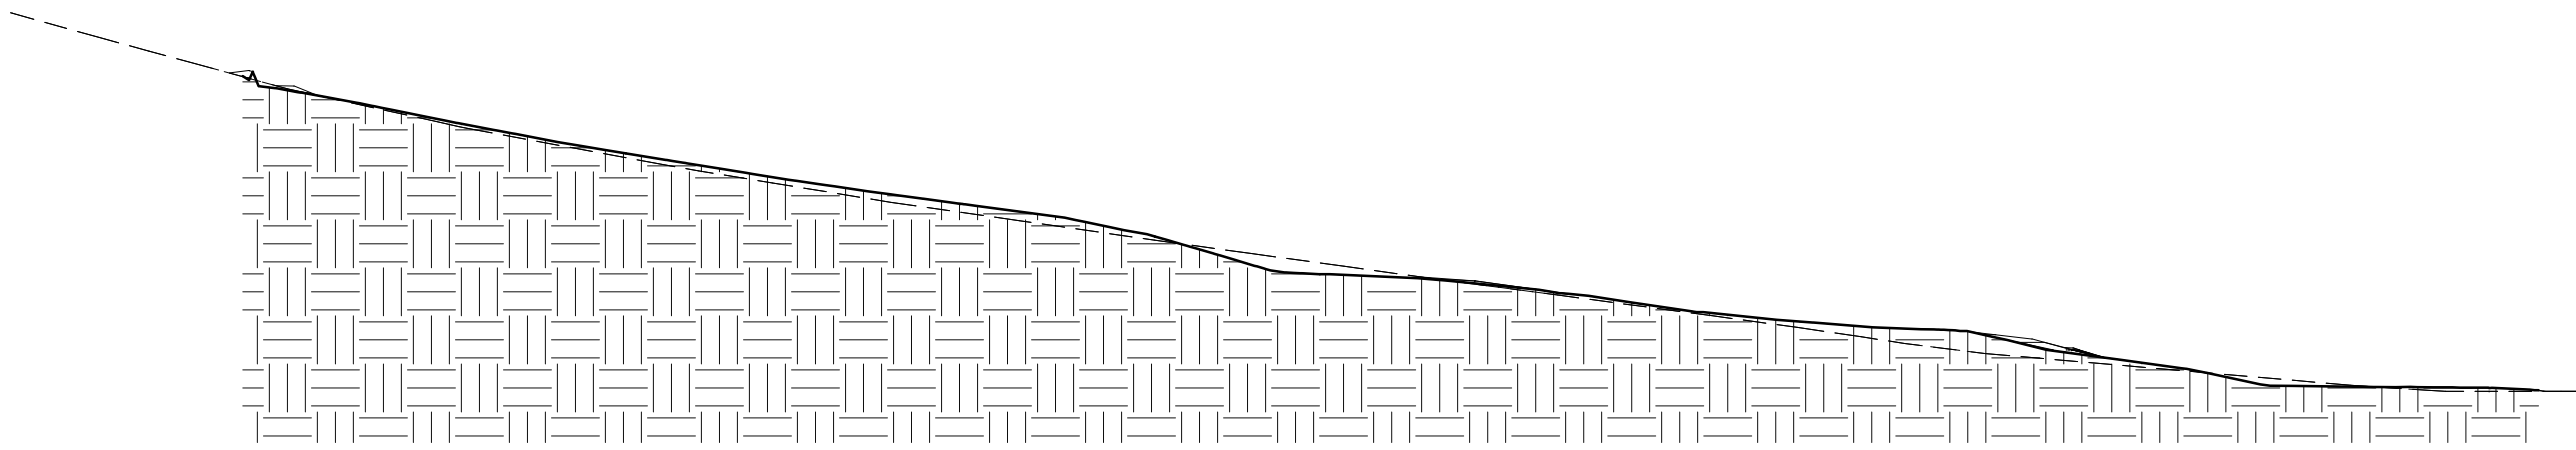

3 SECTION 02
1 : 1000

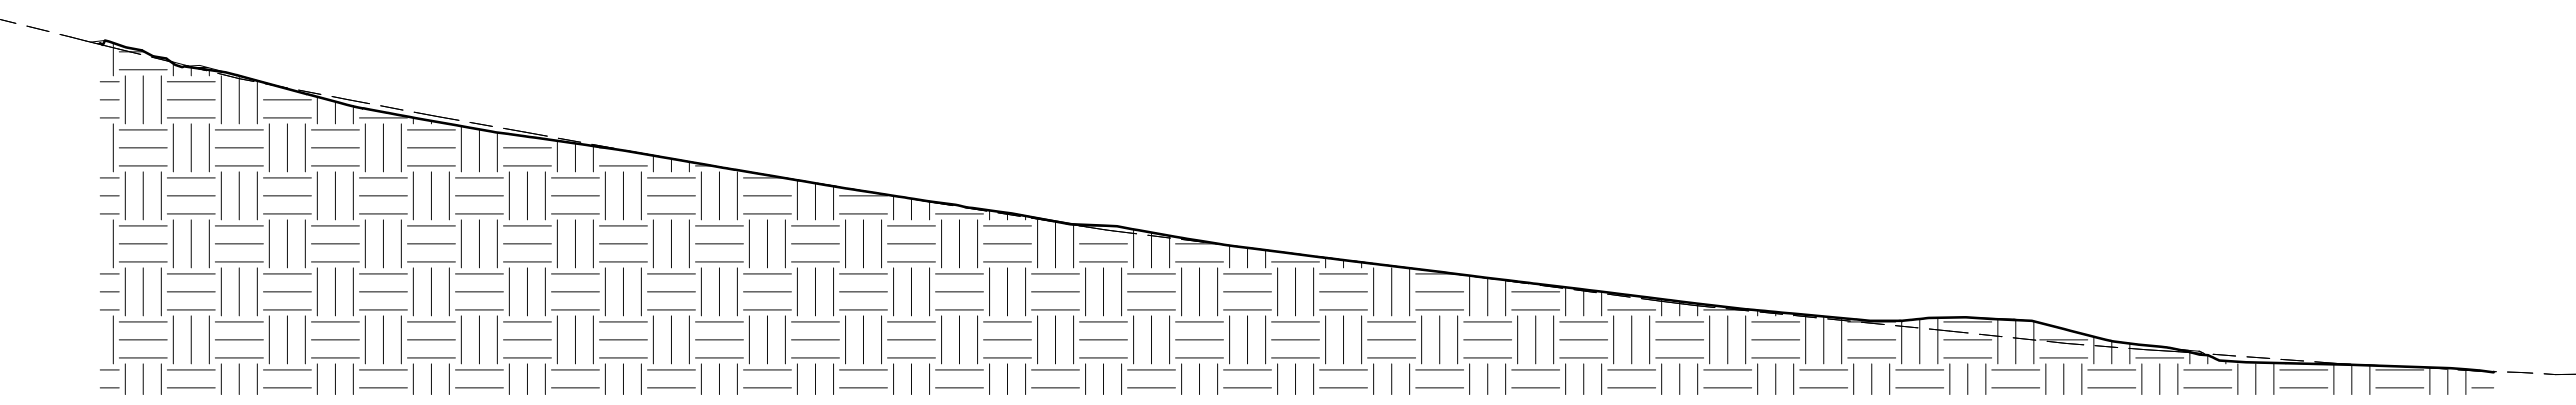

4 SECTION 03
1 : 1000

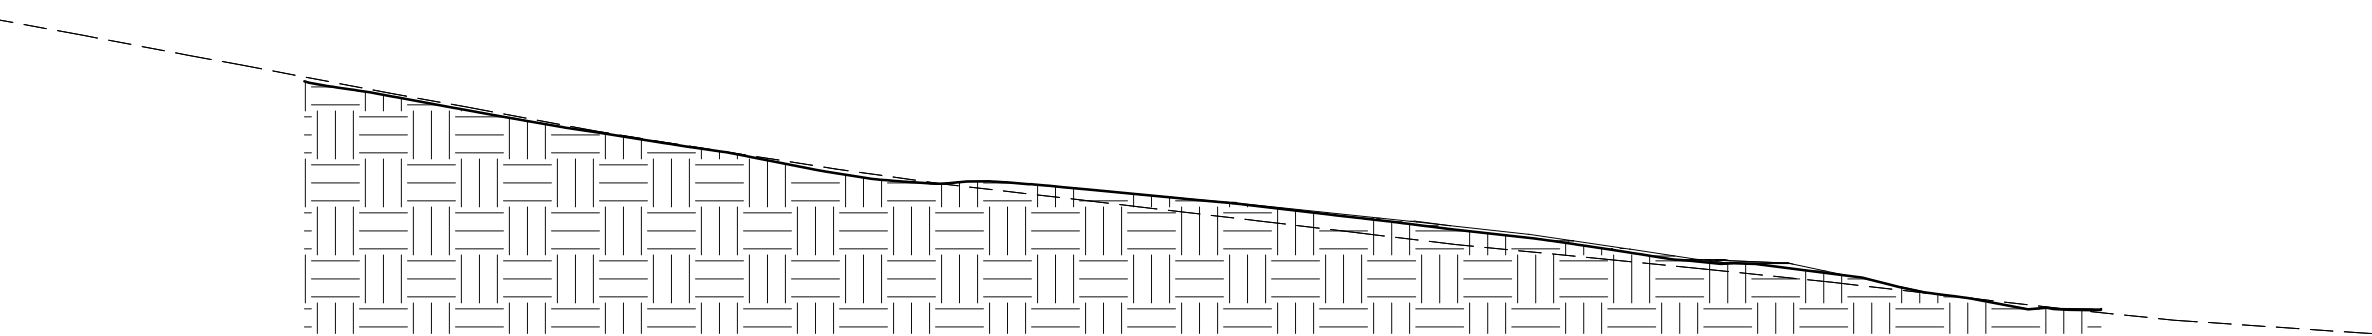

Rev	Description	Date
PROJECT TITLE		
CLIENT		
Maes Y Felin		
Mr R Richards		
Maes Y Felin		
Dinedor		
Hereford		
HR2 6PE		
TITLE		
Site Plan and Sections		
DRAWN BY		
RJ		
REVIEWED BY		
BDE		
DATE		
14/12/15		
SCALE (B A3)		
As indicated		
STATUS		
S2		
PURPOSE OF ISSUE		
Planning		
JOB NO.		
DRAWING NO.		
REV		
15-040		
0001		
Bernard Eacock Ltd		
Planning + Architecture		
1 Fife Street		
Prestonbury		
Herefordshire		
HR2 0SN		
t: 01915 550550		
e: info@bernardeacock.com		
w: www.bernardeacock.com		
This drawing is copyright and owned by Bernard Eacock Ltd.		