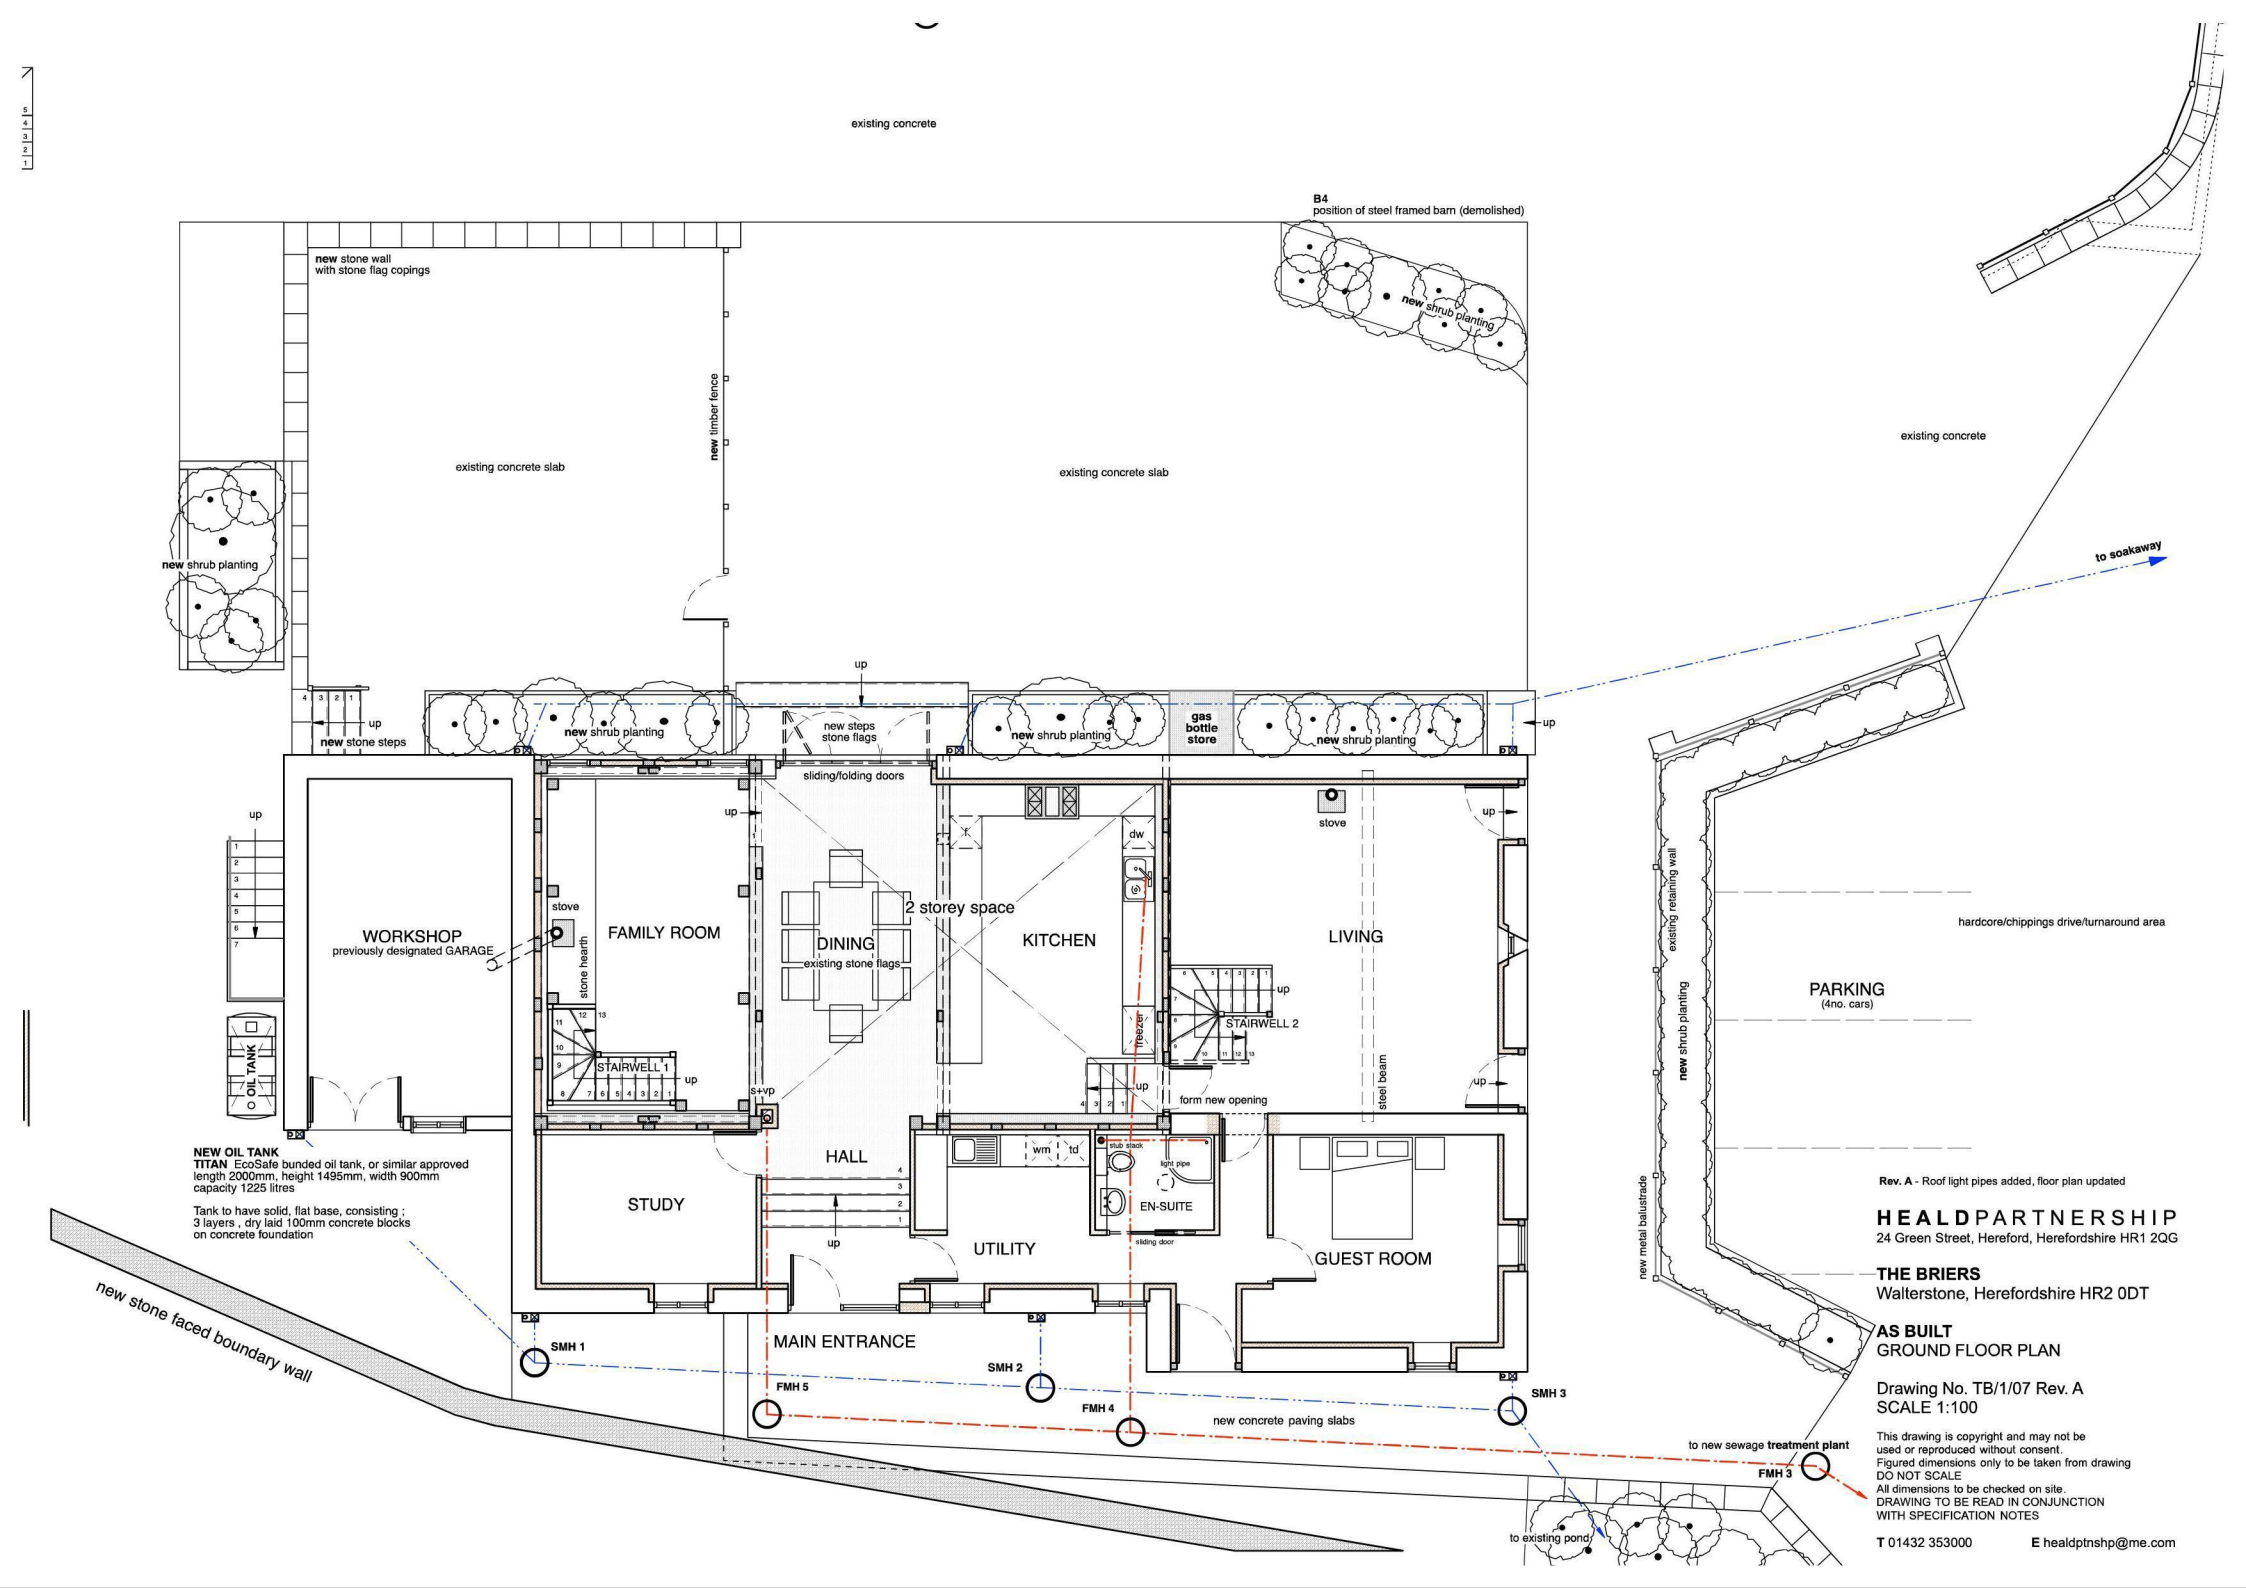

Rev. A - Roof light pipes added, floor plan updated

HEALDPARTNERSHIP
24 Green Street, Hereford, Herefordshire HR1 2QG

THE BRIERS
Walterstone, Herefordshire HR2 0DT

AS BUILT
GROUND FLOOR PLAN

Drawing No. TB/1/07 Rev. A
SCALE 1:100

This drawing is copyright and may not be
used or reproduced without consent.
Figured dimensions only to be taken from drawing
DO NOT SCALE
All dimensions to be checked on site.
DRAWING TO BE READ IN CONJUNCTION
WITH SPECIFICATION NOTES

T 01432 353000 **E** healdptnshp@me.com